



BUILDING SECTION @ LOADING BAY

1  
A206

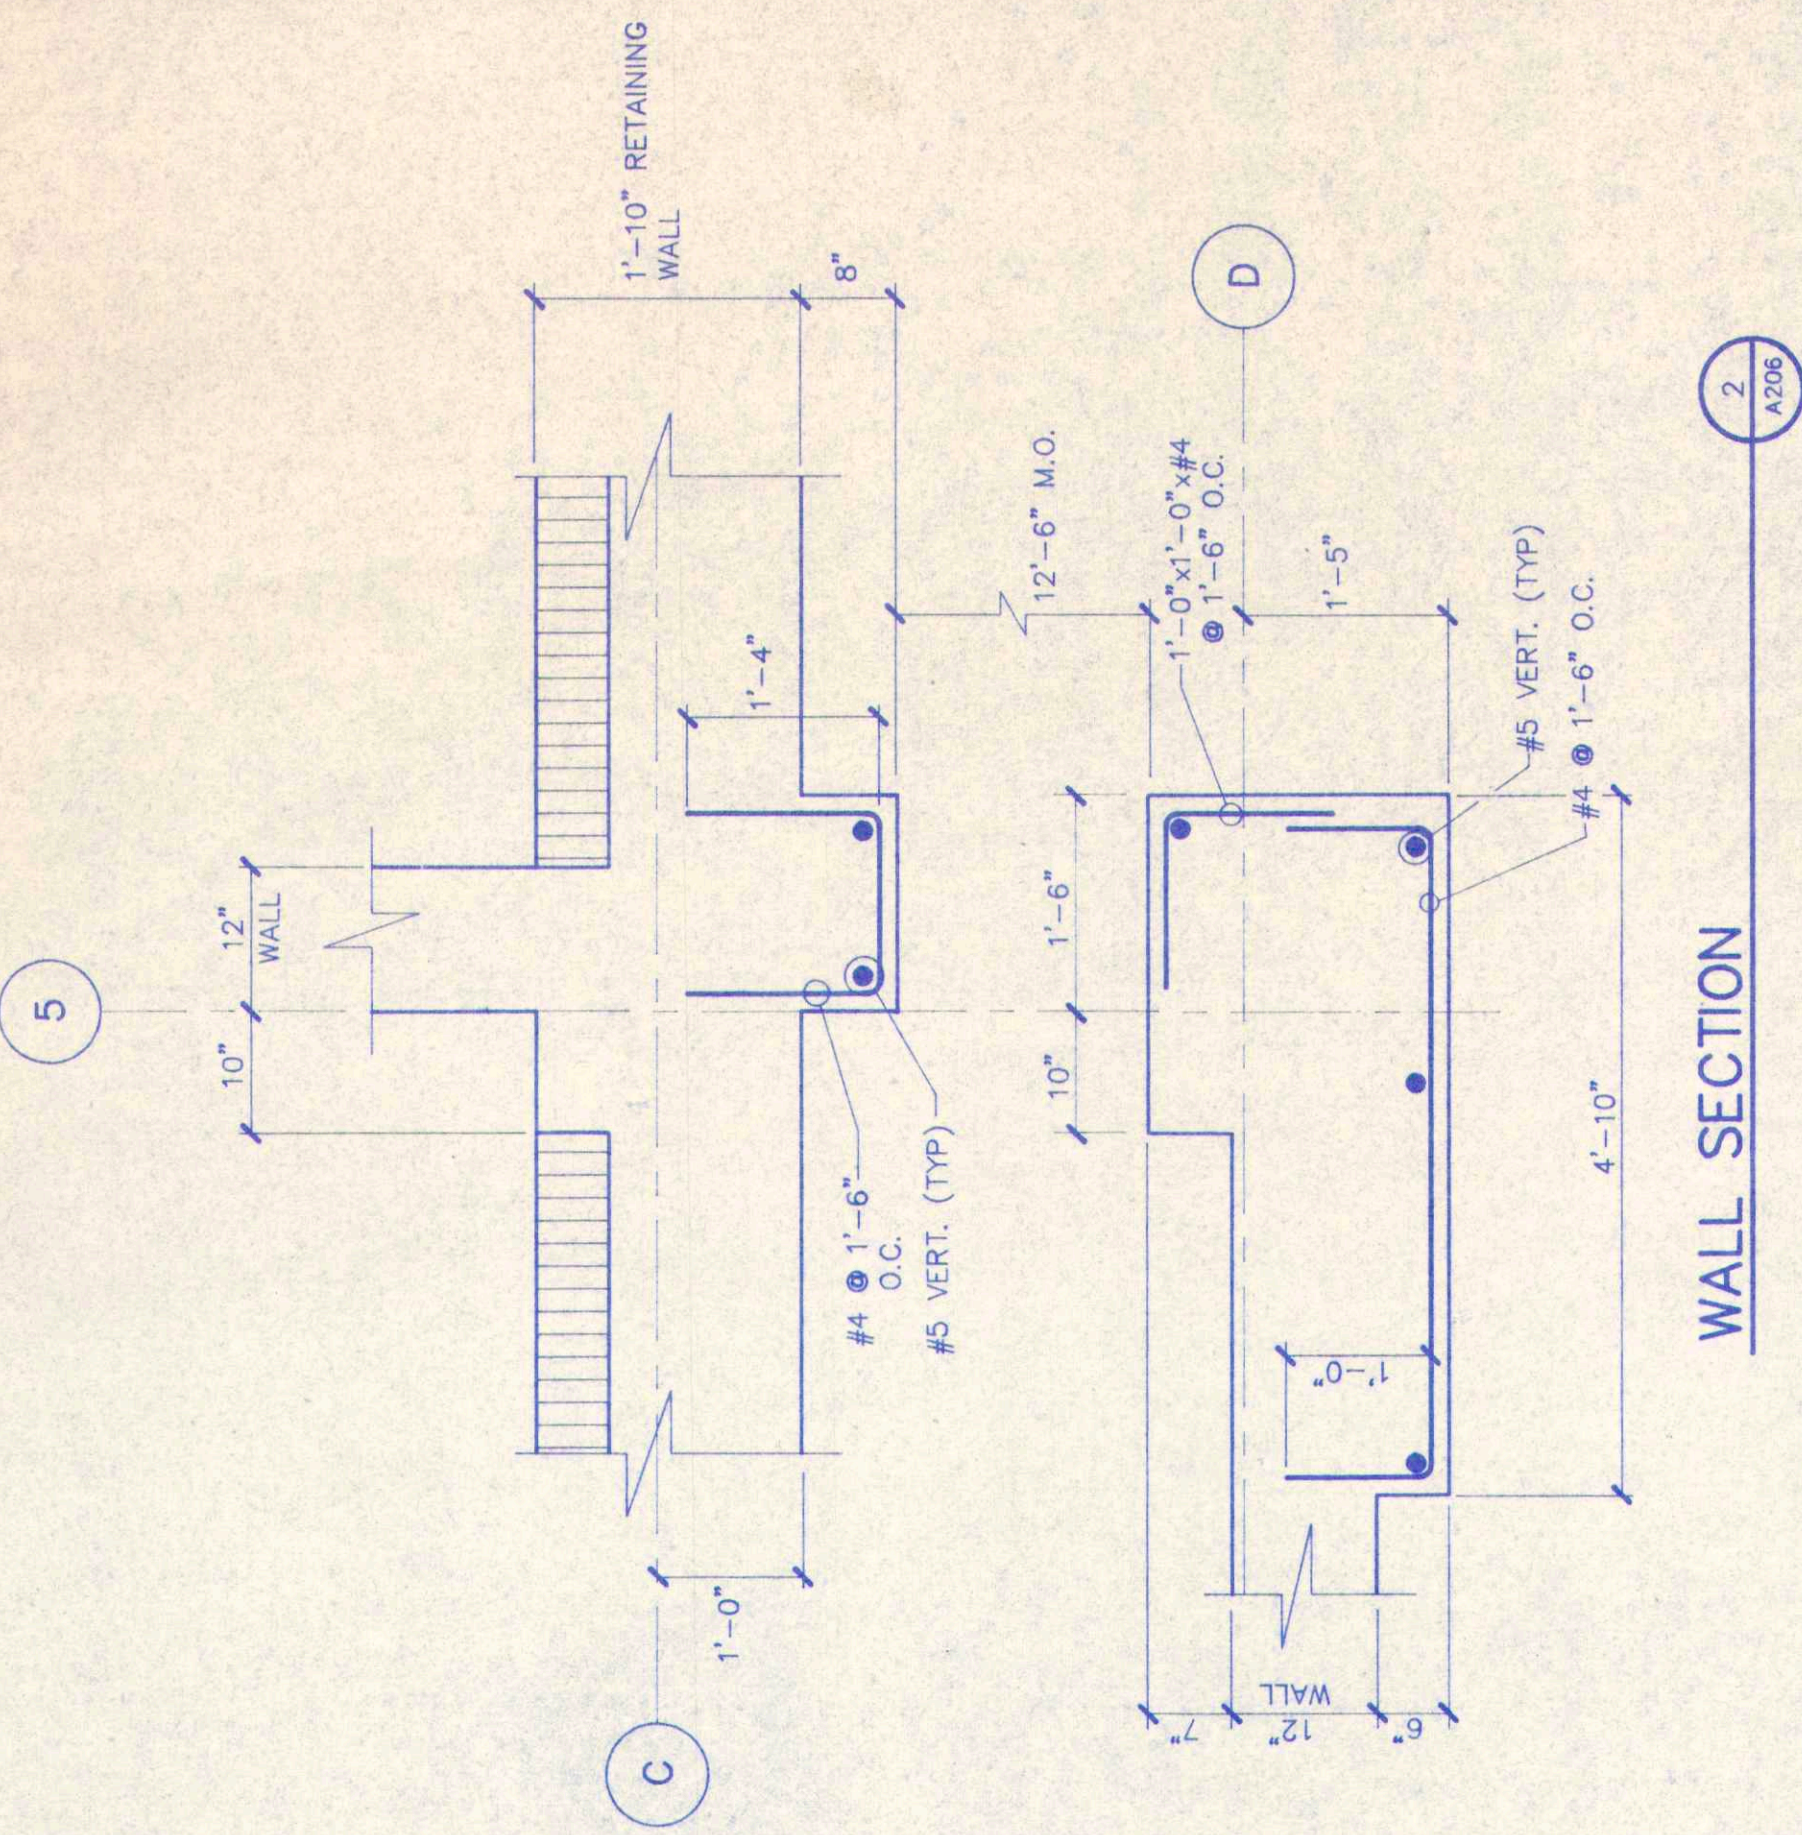

WALL SECTION

2  
A206

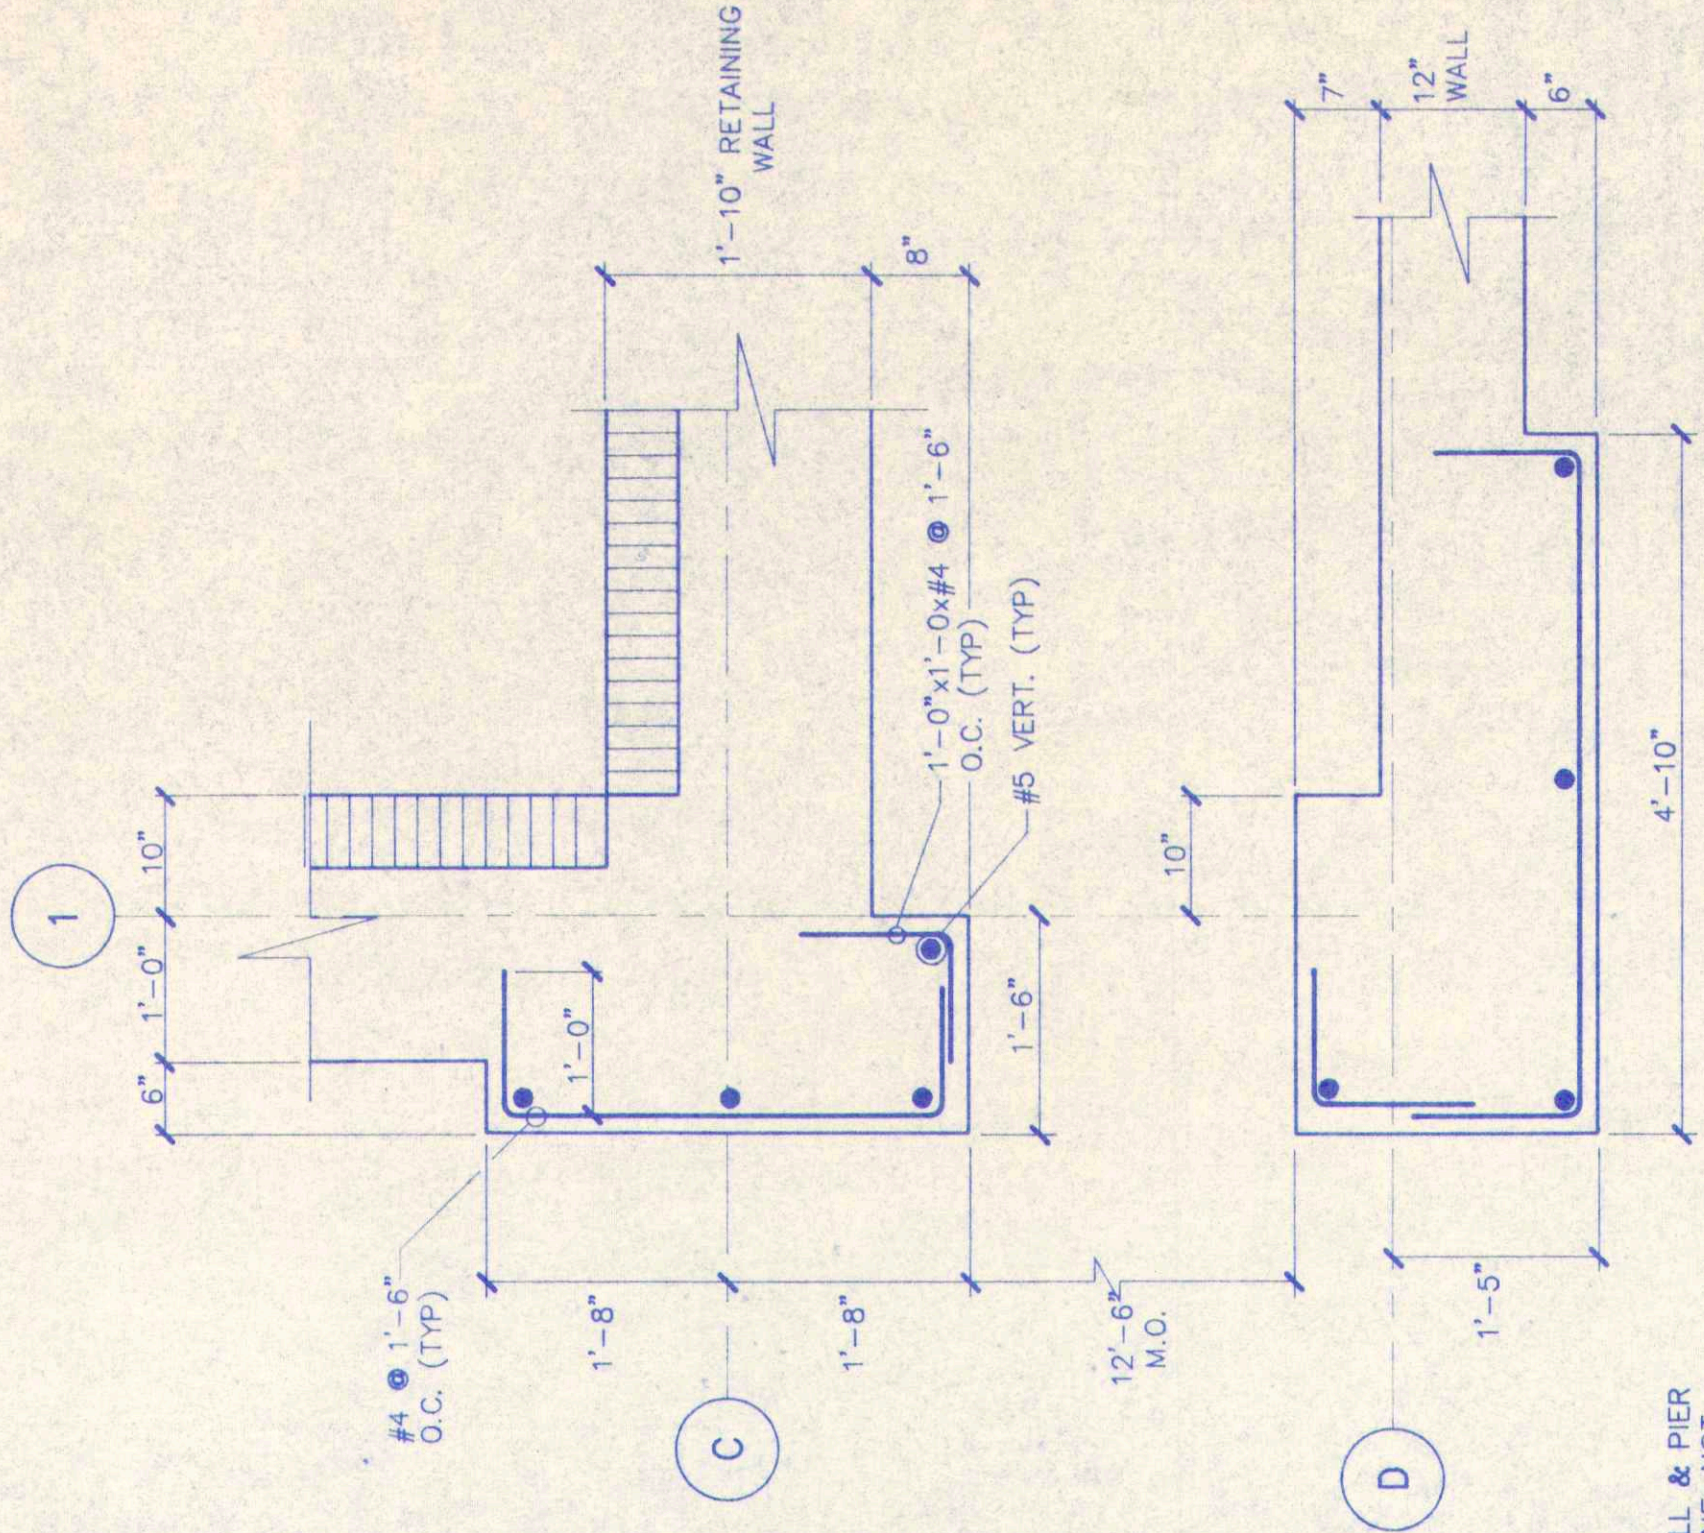

WALL SECTION

3  
A206

NOTE: WALL & PIER REINF. NOT SHOWN

RECORD DRAWINGS

These construction contract drawings have been made for the use of the contractor and are not to be used for any other purpose. The contractor is responsible for checking the drawings for errors and omissions and for making any necessary changes during construction. The contractor is also responsible for obtaining all necessary permits and for complying with all applicable laws and regulations. The drawings are not to be used for any other purpose without the written consent of the engineer.

Drawn By: F.F.E. Date: 10.9.91

revisions

revisions	drawn by	app'd by	date
A) ISSUED FOR BID	R.A.M.	P.F.K.	3/2/90

Alteration of this document except by a licensed Professional Engineer, is illegal.

signature

**SMITH & MAHONEY, P.C.**  
CONSULTING ENGINEERS • SURVEYORS

79 NORTH PEARL STREET ALBANY, NEW YORK



MONTGOMERY COUNTY

**SOLID WASTE TRANSFER STATION**

CITY OF AMSTERDAM • MONTGOMERY COUNTY • NEW YORK

TRANSFER BUILDING — FOUNDATION SECTIONS

Sheet number

A206

35 of 41

REV. NO.

DWG. NO.